


plafondgoot 100x60  
vloergoot 300x30

Bouwplaats: GENT  
Bouwer: ALPHO HQ  

**ELECTRO CLARYSSE**  
Joes de Ister Beertman 58  
8740 Pittem  
mail: info@electro-clarysse.be

plaat: 1  
schaal: 1:500  
datum: 2010-05-15  
Wibgitz  
Geslacht:  
VCCad

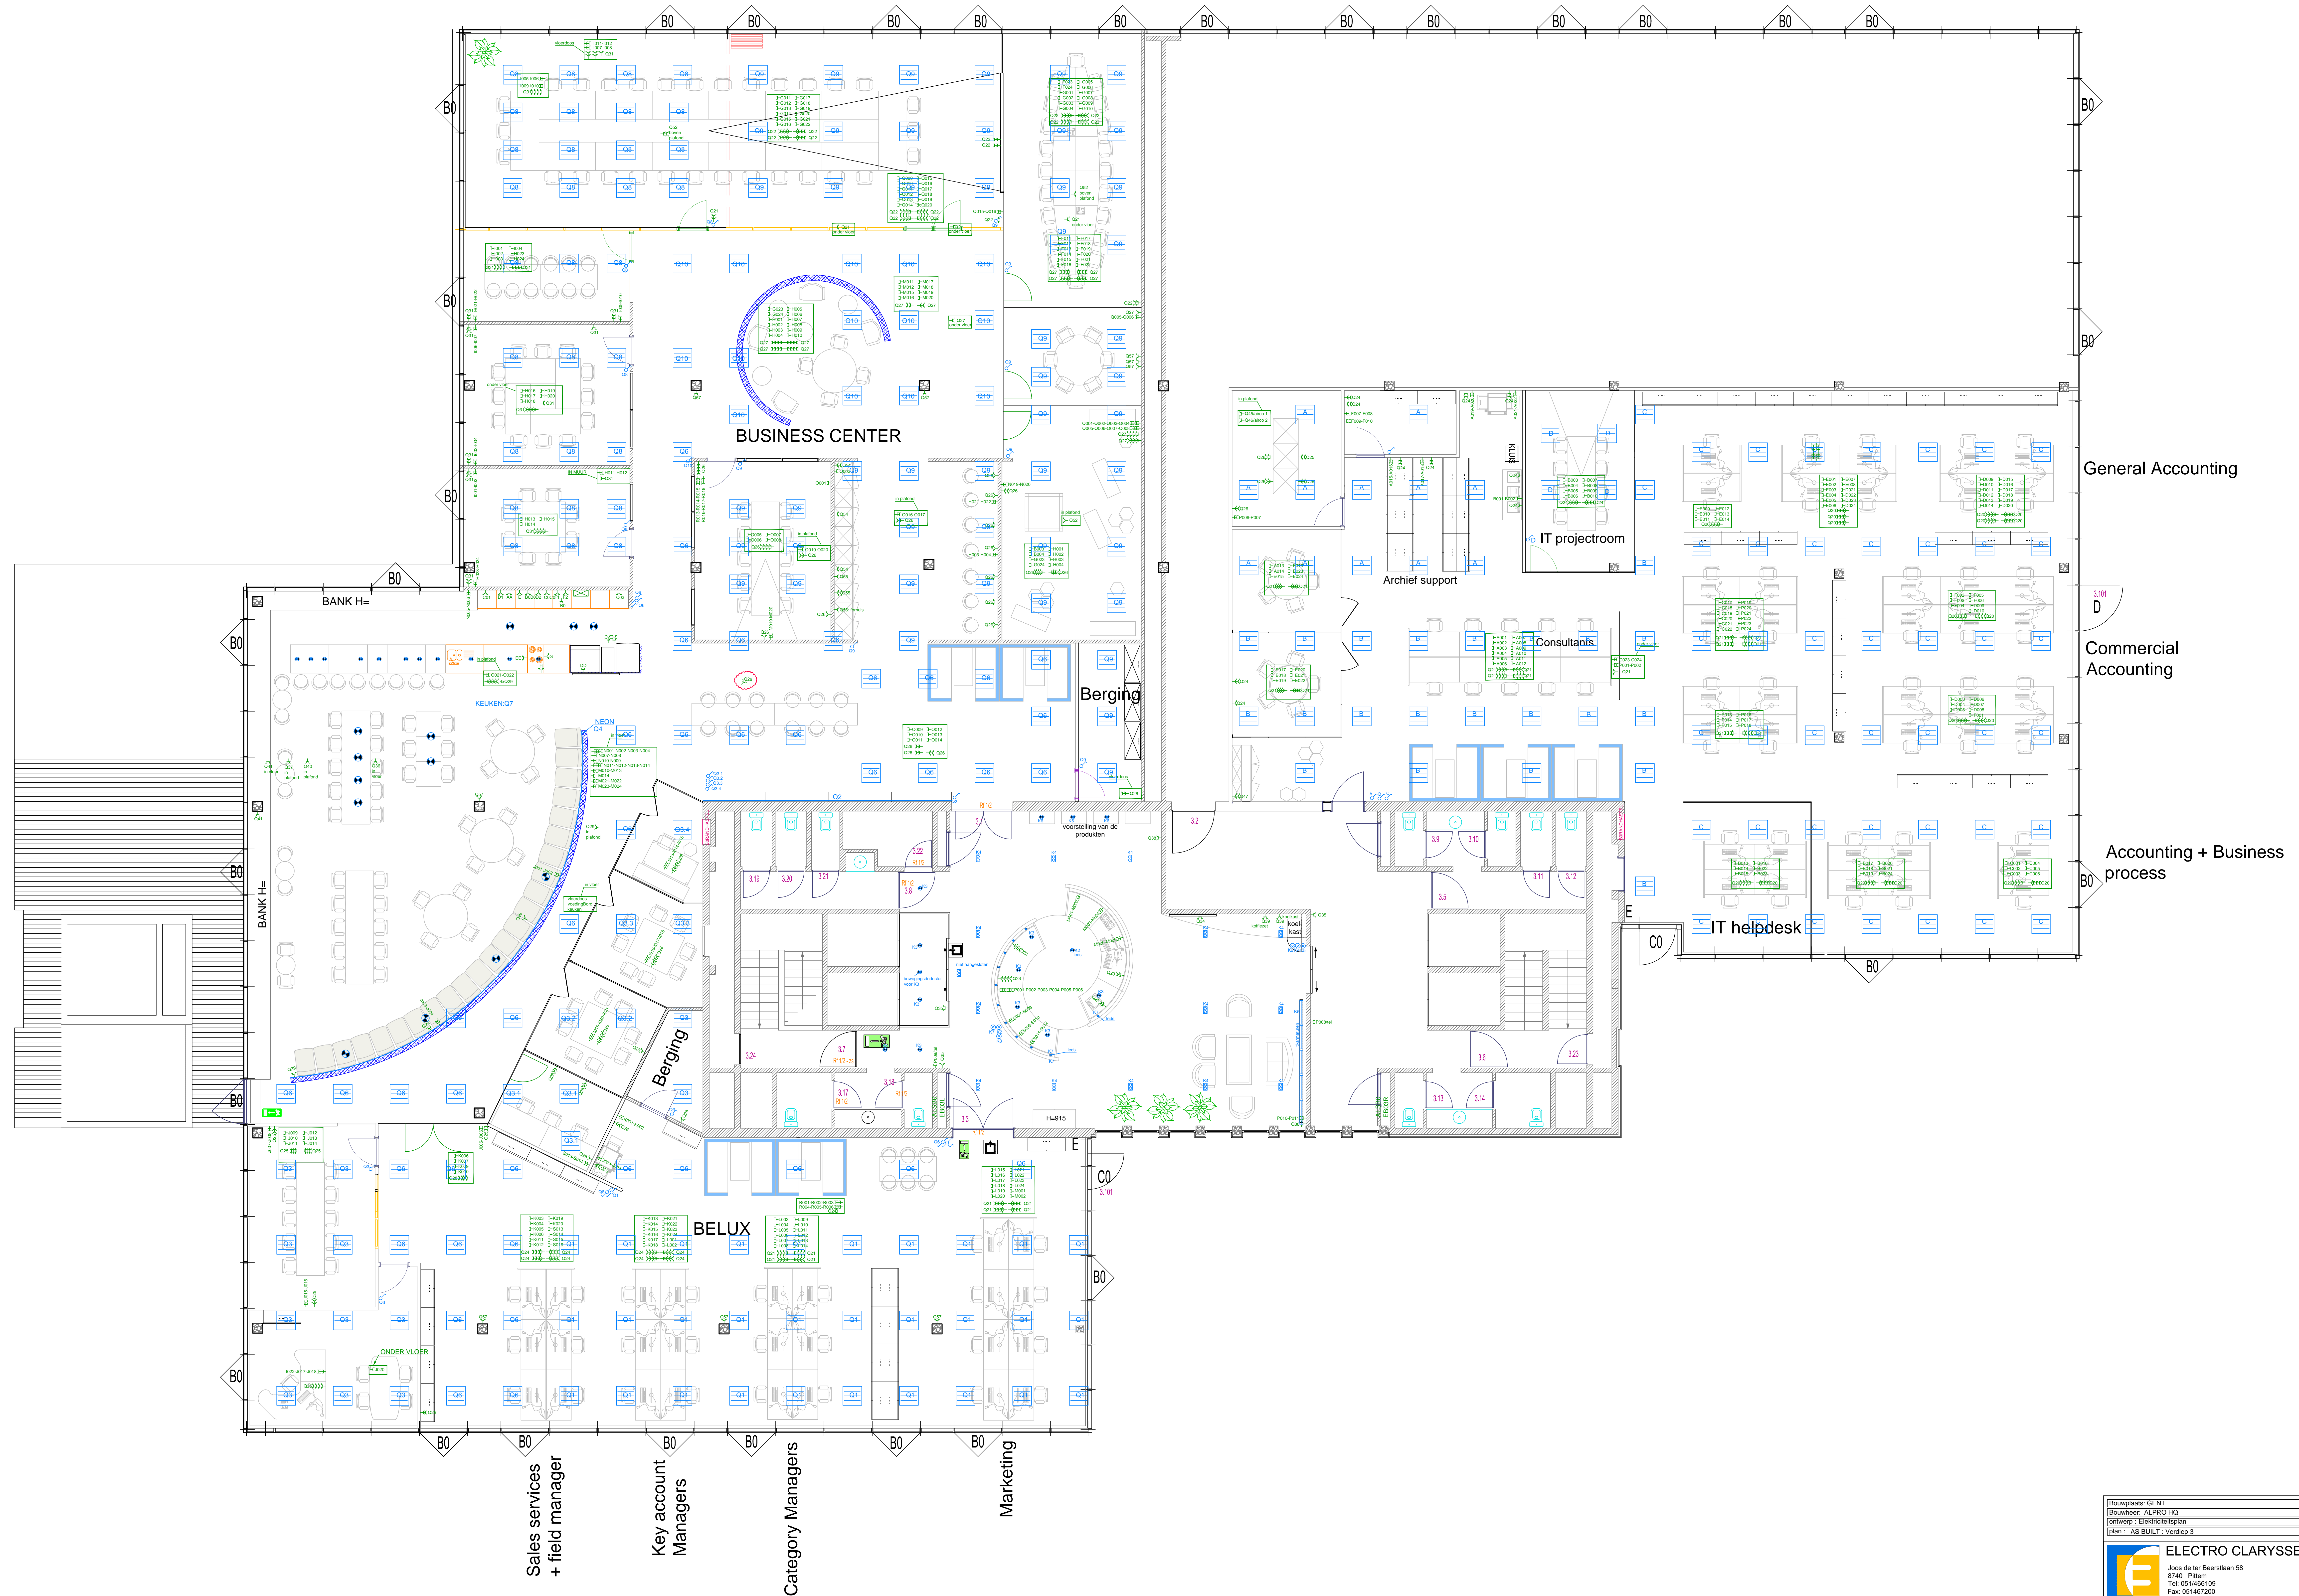

General Accounting

Commercial Accounting

Accounting + Business process